



Hornsea Three

Notice to Mariners

Ref: 08377297_A

Date: 22nd September 2023

1 Introduction

Mariners are advised that Orsted Hornsea Project Three (UK) Limited (hereafter 'Orsted') are investigating a potential transmission fault with the navigational light at the following site:

- ANS3, Lowestoft.

The investigation will be undertaken on the kittiwake artificial nesting structure which was constructed as part of a compensation scheme associated with the Hornsea Project Three Offshore Wind Farm (Hornsea Three) project, located within the UK Sector of the North Sea. The navigational light is reported as being offline, the structure is visible via AIS.

2 Area of operations

The works will take place within the boundaries illustrated in **Figure 1**.

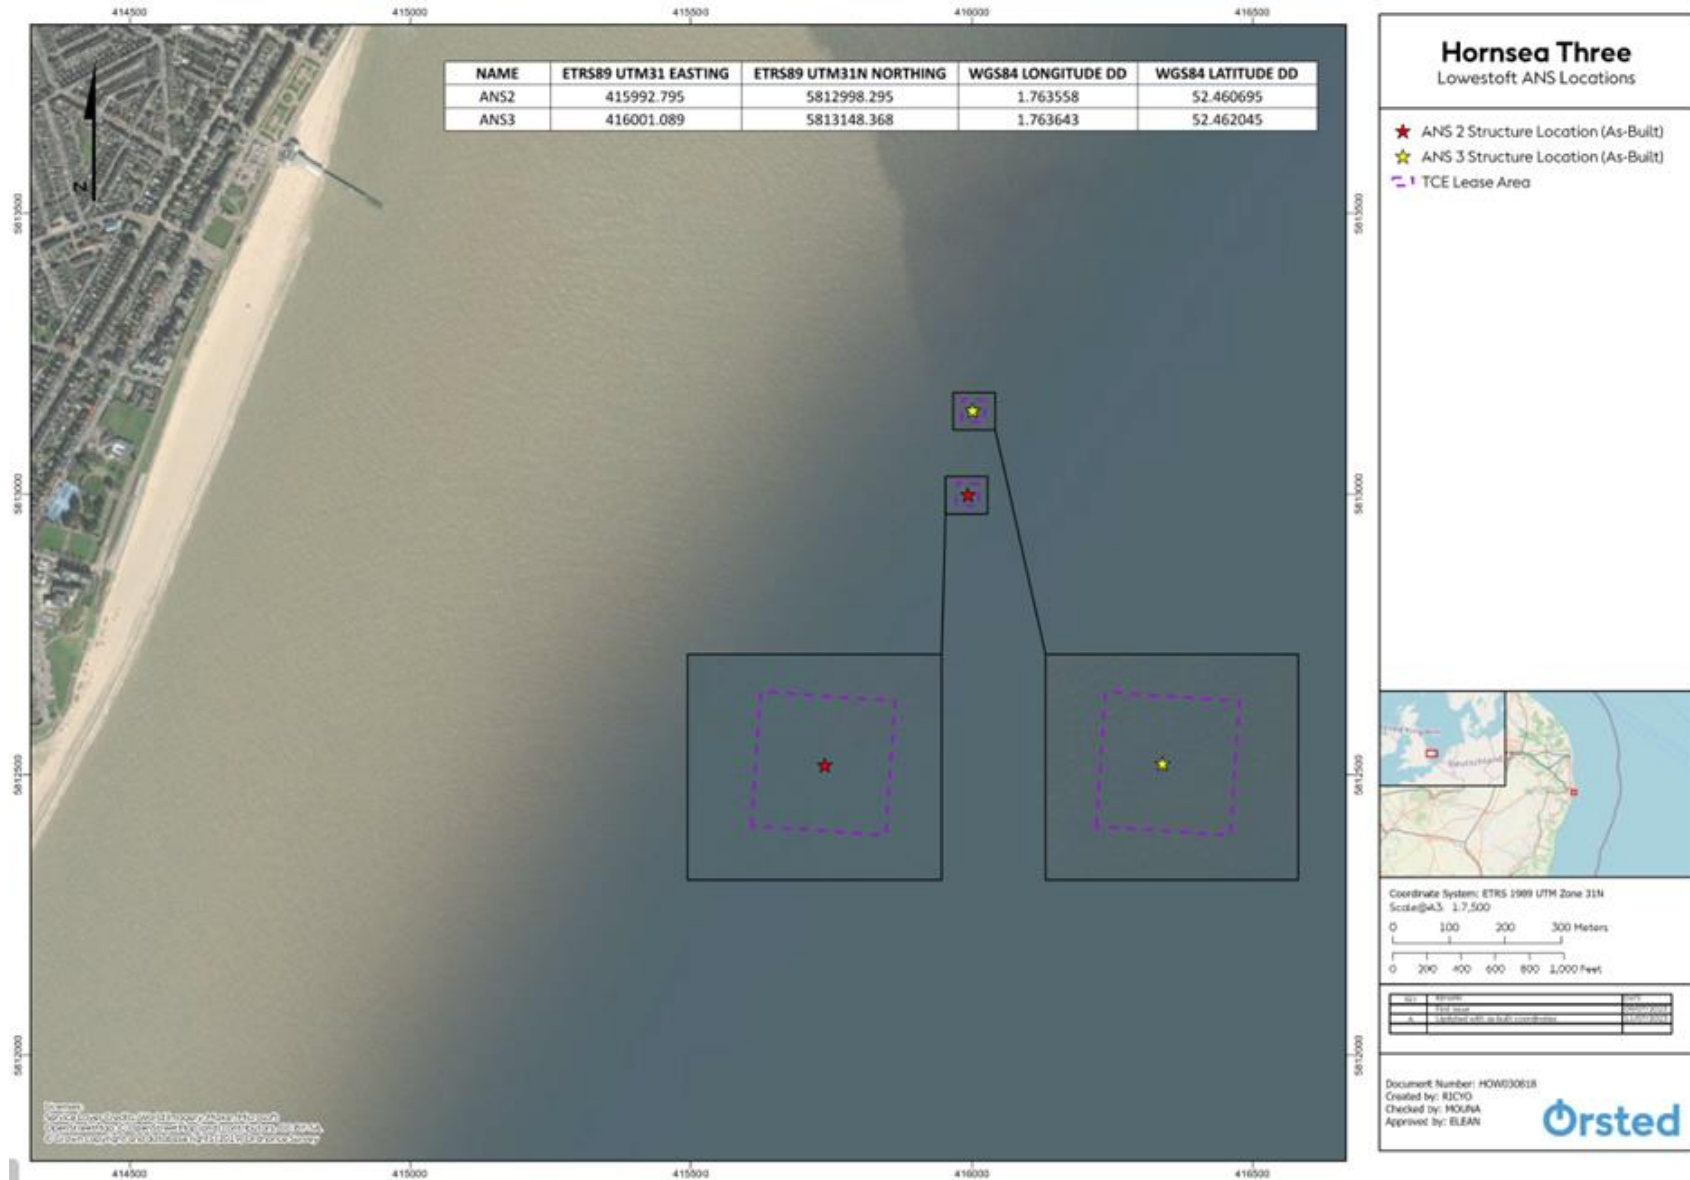


Figure 1: Hornsea Three Artificial Nesting Structures As-built locations – Lowestoft ANS3

3 Proposed activities

3.1 Proposed activity

Hornsea Three are investigating a potential Aids to Navigation (AtoN) transmission failure following a report that the navigational light is offline. The structure is visible via AIS. The notice will be updated accordingly should there be a change to the proposed activity or on completion of works.

4 Immediate contacts

The contents of this notice are based upon our current understanding of Orsted's requirements. Enquiries regarding the contents of this Notice to Mariners or any other matters should be directed to:

Project Manager (Orsted)	Richard Swann	
	Tel: +44 7825 753896	E-mail: riswa@orsted.com

5 Fisheries Liaison

Fisheries Liaison is provided by Lee Thompson (Company Fisheries Liaison Officer) who can be contacted on:

Email: LEETH@orsted.com	Tel: +44(0) 7435 600351
---	-------------------------

Out of standard office hours (Monday-Friday 9am-5pm).

6 Coordinates

Lowestoft ANS3 As-built location

Latitude DD (WGS84)	Longitude DD (WGS84)
52.460695	1.763558
Easting ETRS89 (UTM31)	Northing ETRS80 (UTM31N)
415992.795	5812998.295