



# Hornsea Three

## Notice to Mariners

Ref: 08050062\_A

Date: 17/12/2025

### 1 Introduction to proposed activities


Mariners are advised that Orsted Hornsea Project Three (UK) Limited (hereafter 'Orsted') is investigating an Aids to Navigation (AtoN) transmission fault at ANS3 located in Lowestoft following a report that the structure is not visible via AIS and the navigational light is displaying the incorrect characteristic.

An official notification has been issued through the Local Aids to Navigation Reporting System (LARS). This update will be broadcast on VHF Channel 16.

The timing of the inspection and remedial works is subject to vessel availability and weather conditions. This Notice shall be updated accordingly should there be a change to the proposed activity or on completion of works.

### 2 Area of operations

The location of ANS3 is shown in [Figure 1](#) below and coordinates are provided in [Section 5](#) of this notice.

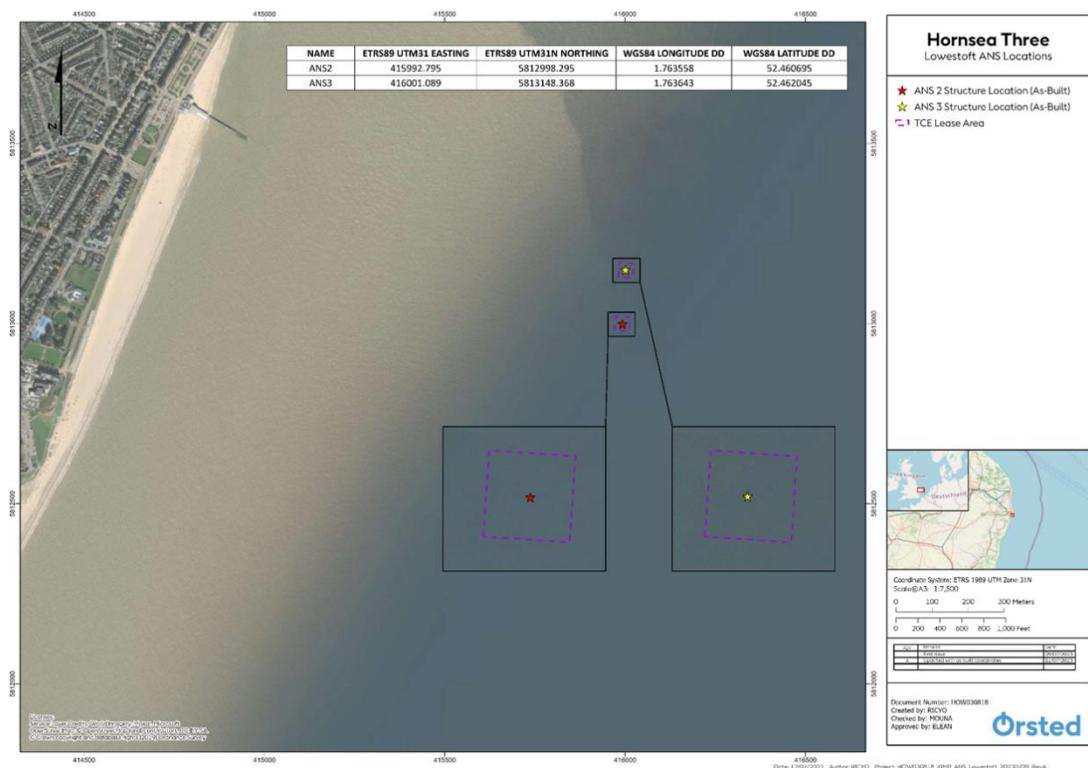

**Figure 1 - ANS2 As-built location**

### 3 Immediate contacts

The contents of this notice are based upon our current understanding of Ørsted's requirements. Enquiries regarding the contents of this Notice to Mariners or any other matters should be directed to:

<b>Marine and Helicopter Coordination Centre (MHCC)</b>	24/7 contact
	Tel: +44 (0) 2078 111 170      E-mail: MHCC_DEV_ADM@orsted.com

### 4 Fisheries Liaison

Offshore Fisheries Liaison is provided by Adrian Woods (Hornsea Three Fishing Industry Representative):

<b>Offshore Fishing Industry Representative</b>	Ady Woods
	Tel: +44 (0)7468 898948

Standard office hours (Monday-Friday 9am-5pm)

### 5 Coordinates

Lowestoft ANS3 As-built location

#### Latitude DD (WGS84)

52.462045

#### Longitude DD (WGS84)

1.763643